



PLAN OF CONTROL BUILDING
Scale 1:100

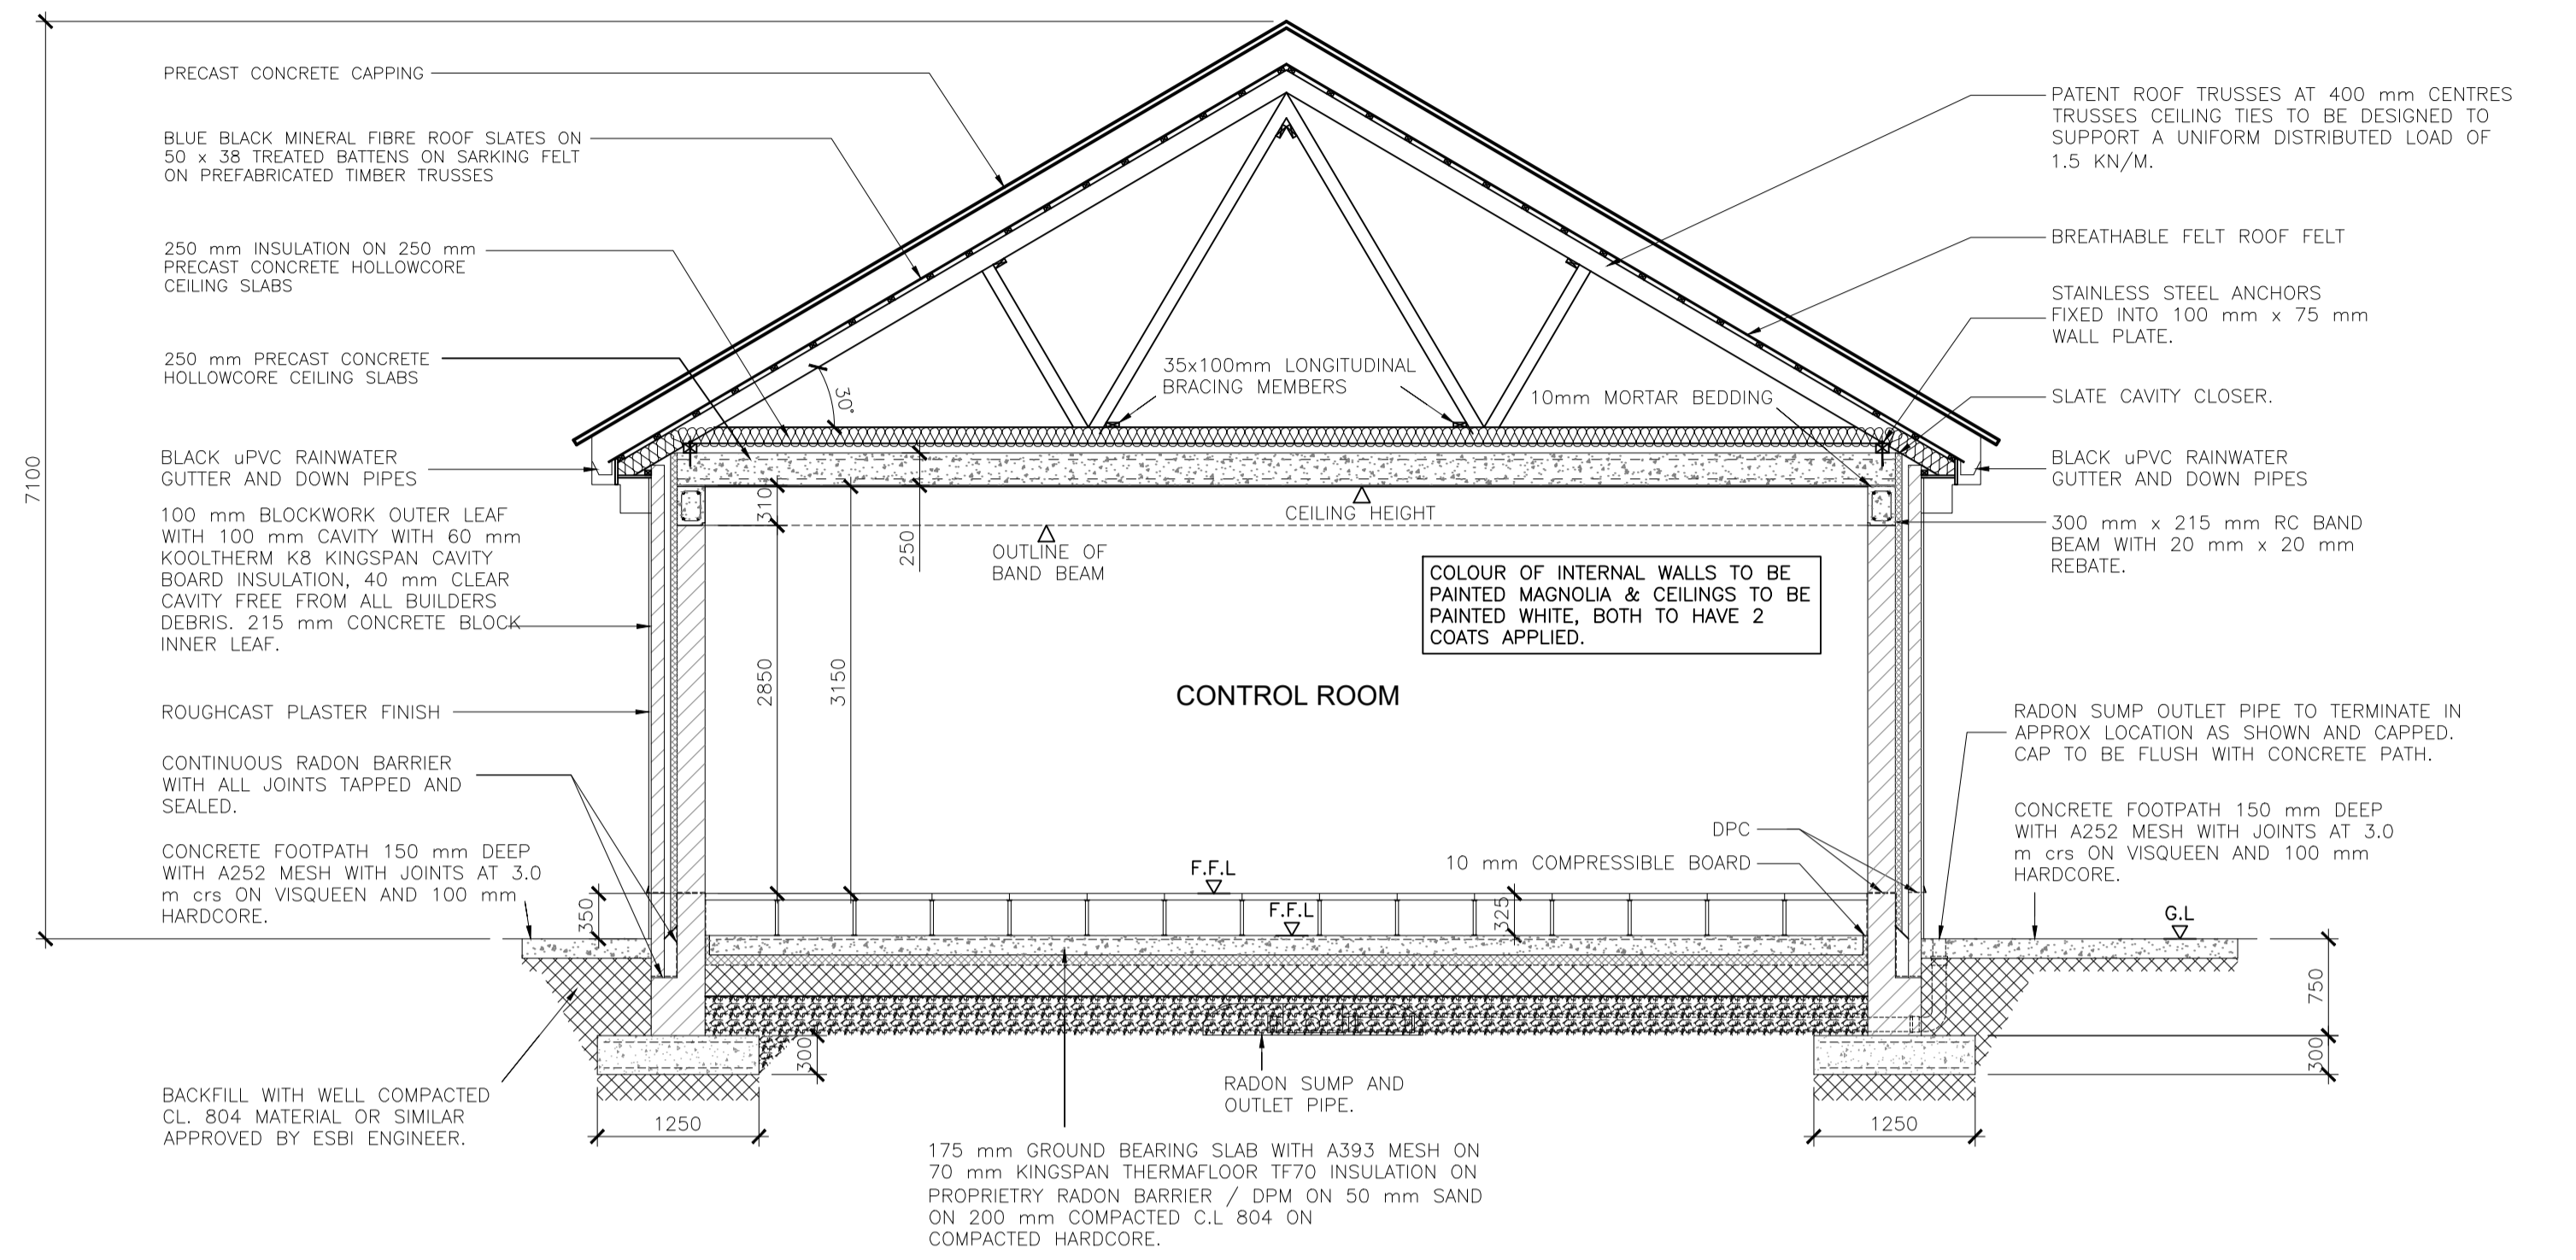

SECTION A
SCALE 1:50

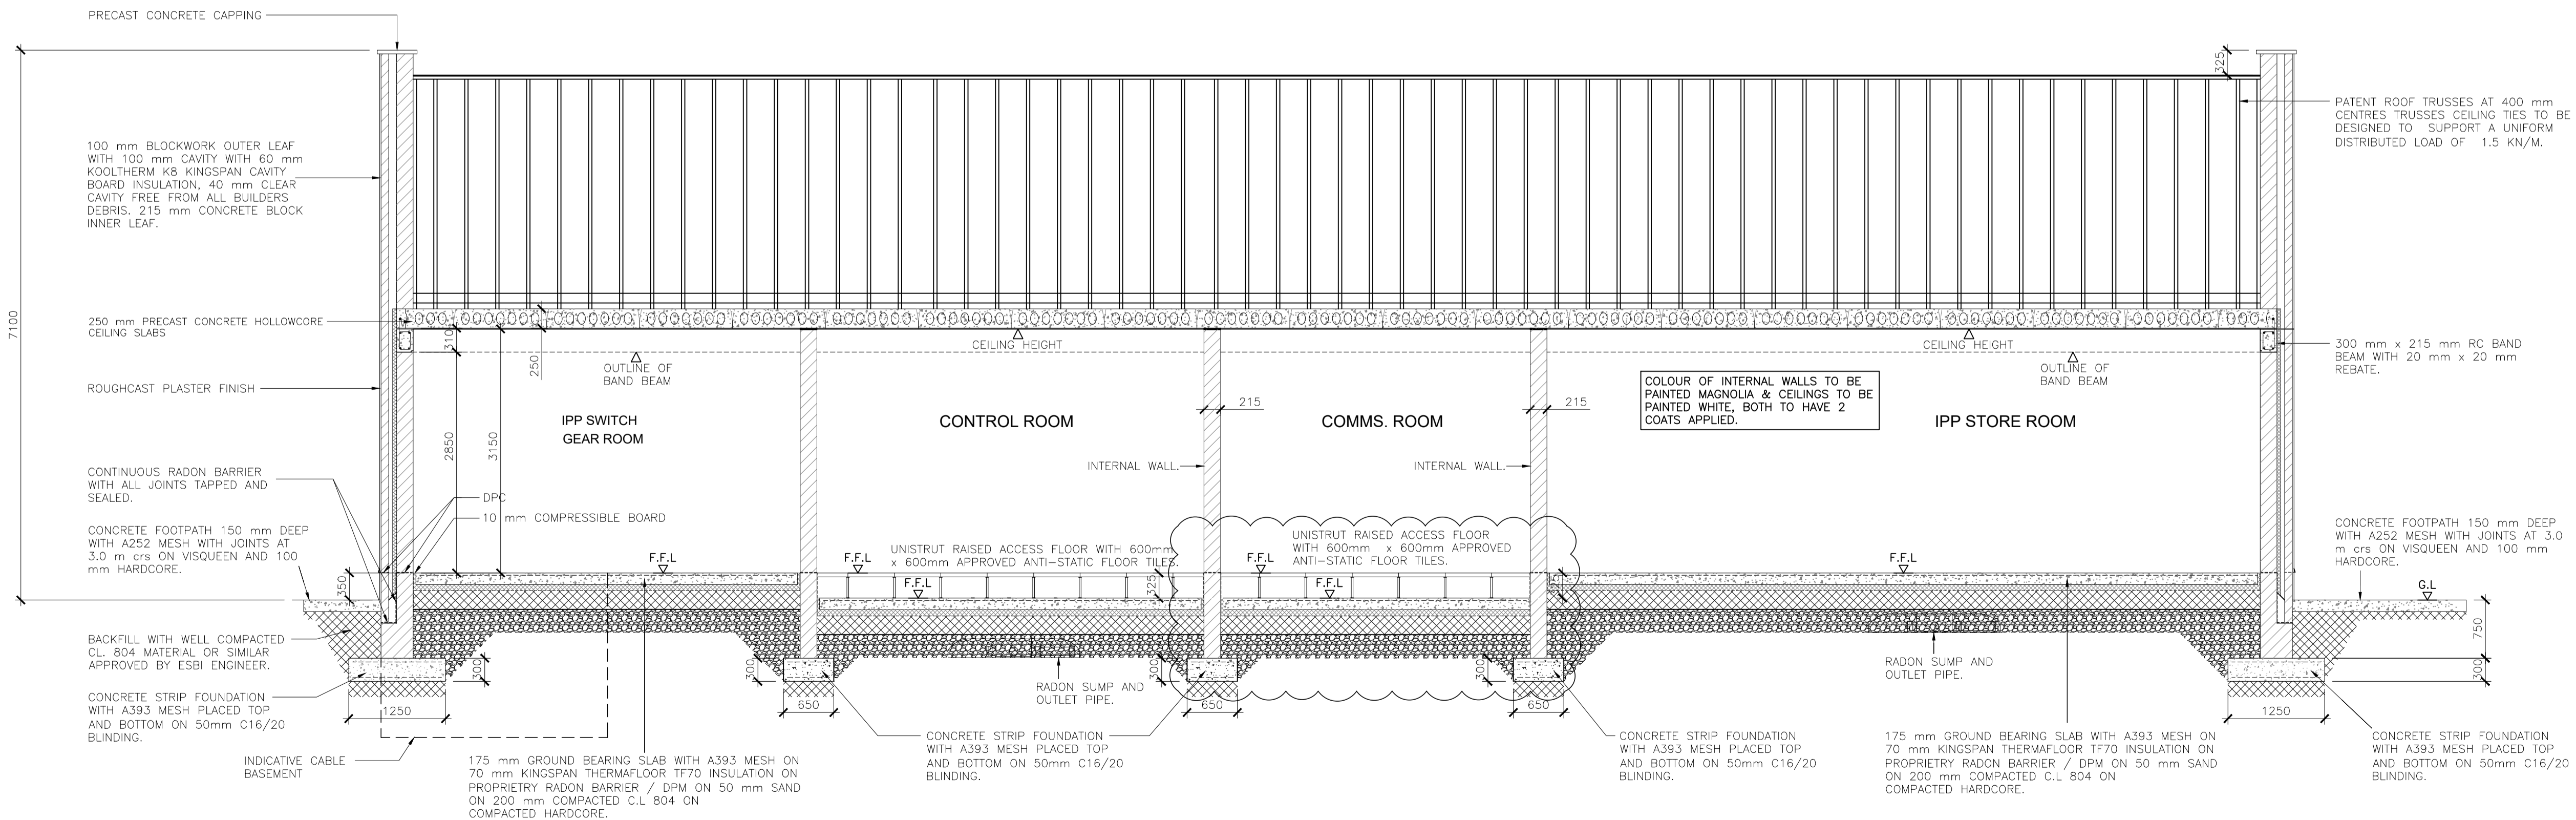

SECTION B
SCALE 1:50

REV.	DATE	REVISION DESCRIPTION	DRN	PROD	VER	APP
2	06.12.18	CLIENT NAME REVISED	SB	SB	BL	DS
1	27.06.18	ISSUED FOR PLANNING	SB	PC	BL	DS
0	16.02.18	ISSUED FOR PLANNING	RK	RK	BL	DS

PURPOSE OF ISSUE - PRELIMINARY UNLESS INDICATED

TENDER CLIENT APPROVAL CONSTRUCTION AS-BUILT REVISED

Client: **ESB WIND DEVELOPMENT LTD. AND BORD NA MÓNA POWERGEN LTD.**

Project: **TIMAHOE NORTH SOLAR FARM**

Contract:

Drawing Title: **TIMAHOE NORTH SOLAR FARM IPP SWITCHGEAR BUILDING PLAN AND SECTIONS**

Production Unit: **ESB WIND DEVELOPMENT LTD**

**One Dublin Airport Central,
Dublin Airport, Cloughran, Co. Dublin**
 Tel: 353 1 703 8000 Email: marketing@esbi.ie
 Web: www.esbinternational.ie
 ESB International is a trading name of
 ESB Engineering & Facility Management Ltd.
 Registered Office: as above Registered in Ireland No. 155249

DRAWN	PRODUCED	VERIFIED	APPROVED	APPO DATE
S. Bolton				
CLIENT REF	No. of Site	SIZE	SCALE	
TC219344	1	A1	AS SHOWN	
DRAWING NUMBER	SHEET	REV		
PE605-D025-005-001-002				

COPYRIGHT © ESB ENGINEERING & FACILITY MANAGEMENT LIMITED.
All rights reserved. No part of this work may be modified or reproduced or copied in any form or by any means, graphic, electronic or mechanical, including photocopying, recording, taping or information-and-retrieval system, or used for any purpose other than its designated purpose, without the written permission of ESB Engineering & Facility Management Ltd.